

CITY OF RENTON, WASHINGTON
SR 900 HOV AND HOUSER CONNECTION (SCHEDULE A)
 BRONSON WAY N. TO BEGINNING OF UNDERCROSSING (SR900-4+95 TO H-14+43)
 (ISTEA PROJECT #MO-0900(007) AND (TIA PROJECT #9P-102(006)-1))


HOUSER WAY NORTH RELOCATION (SCHEDULE B & C)
 SCHEDULE B - BEGINNING OF UNDERCROSSING TO LIMITED ACCESS (H14+43 TO H18+20.24)
 SCHEDULE C - LIMITED ACCESS TO N. 8TH ST. (H18+20.24 TO HW205+00)

ISTEA PROJECT #DPU-0076(1)

STPF-1175(2)

INDEX OF DRAWINGS

SHEET NO.	DESCRIPTION	SHEET NO.	DESCRIPTION
1	STANDARD LEGEND AND SYMBOLS	39	SIGNAL PLAN HOUSER WAY N./N. 8th ST.
2-4	SUMMARY OF QUANTITIES	40	WIRING DIAGRAM HOUSER WAY N./N. 8th ST.
5-7	TYPICAL ROADWAY SECTIONS	41	SIGNAL STANDARD DETAIL CHART
8	DRAINAGE SECTIONS	42-57	WALL PLANS AND DETAILS
9	DRAINAGE DETAILS	58-80	UNDERCROSSING STRUCTURE PLANS AND DETAILS
10	WATER MAIN DETAILS	81-84	SIGN BRIDGE LAYOUT AND DETAILS
11-25	PLAN AND PROFILE SHEETS	85	CONSTRUCTION DETOUR AND SIGNING PLAN STAGE 1 AND 2
26	WATERLINE PROFILE	86-91	LANDSCAPING PLANS
27	STREET LIGHTING SCHEMATIC AND DETAILS	92	LANDSCAPING DETAILS
28-30	UNDERCROSSING ILLUMINATION PLAN	93	IRRIGATION PLAN
31	CHANNELIZATION AND SIGNING DETAILS	94	IRRIGATION DETAILS
32-38	CHANNELIZATION, SIGNING, & ILLUMINATION		

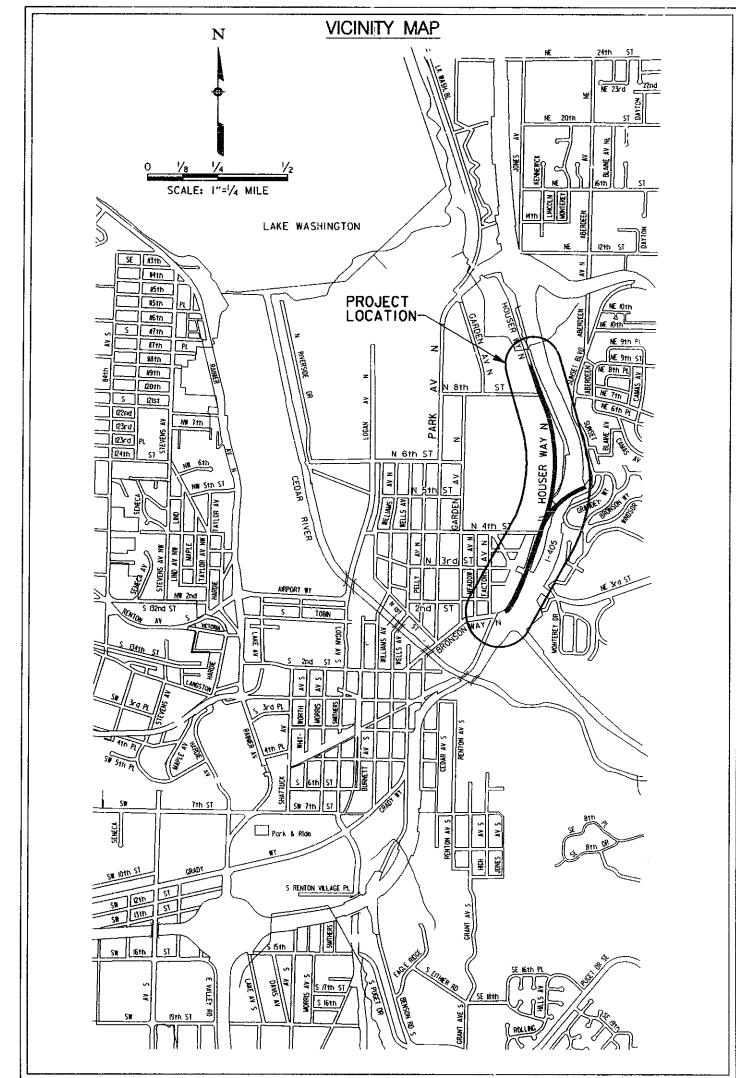

R-226501

RECORD DRAWING

REVIEWED FOR COMPLIANCE TO CITY'S STANDARDS
<i>Mel Wilson</i> 3-27-95 TRANSPORTATION SYSTEMS DIRECTOR
<i>Ronald L. Olson</i> 27 MAR 95 UTILITY SYSTEMS DIRECTOR
<i>J. Gannley</i> 27 MAR 95 MAINTENANCE SERVICES DIRECTOR
<i>Neil Watts</i> 27 MAR 95 PLAN REVIEW
<i>Willie E. Johnson</i> 27 MAR 95 FIRE MARSHALL

EXPIRES 8-22-96
 SHEETS 1 THRU 27 AND 31 THRU 85 OF 94 THESE PLANS SHALL BE DEEMED APPROVED BY THE SIGNATURE AND SEAL ON THIS SHEET.
 3/26/95
 DATE

ISTEA



WASHINGTON STATE TIB (TIA) PROJECT



ENTRANCO
 ENGINEERS · SCIENTISTS · PLANNERS · SURVEYORS
 WASHINGTON ARIZONA CALIFORNIA

760-46-2265

TED - 40 - 2265
 SR 900 HOV/HOUSER WAY N RELOCATION
 Page 01 of 75

R-226501

AR: R-226501